



**GOVERNMENT OF ASSAM**  
**OFFICE OF THE ASSISTANT EXECUTIVE ENGINEER, PWD (BUILDING)**  
**ABAHAYAPURI SUBDIVISION**

NO:- 351-A

DATE :- 11/09/2017.

**FITNESS CERTIFICATE**  
**TO WHOM IT MAY CONCERN**

With reference to the survey and completion report of the supervising Civil Engineer, I hereby certify that building, which is situated at Dakhin Dhaligaon, RC-Bongaigaon, DIST- Bongaigaon, ASSAM and owned by Sri Profulla Kumar Brahma as per description attached with drawing and certified plan at whose plans were sanctioned competent authority has been inspected with reference to building bye-law in respect to the structural safety, fire safety, hygienic and sanitary conditions inside and in the surroundings and is declared fit for occupation and release of regular water and electricity connection. The description of the construction work completed

is given in the attached drawing as under :

Description of Construction Work Block-wise/Building wise / Floor wise


1. Location of Building
2. Details of completed work floor wise
3. Enclosed : As-built plan


B


ASSISTANT EXECUTIVE ENGINEER, PWD (BUILDING)  
Asst. Executive Engineer, P.W.D.  
ABHAYAPURI, PWD (BUILDING) SUBDIVISION  
Abhayapuri Building Sub-Division  
SEAL:- Abhayapuri

DATE :-


11-09-17

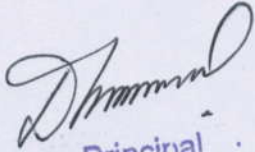  
Principal  
PKM E.M. School, Dhaligaon  
Bongaigaon, Assam

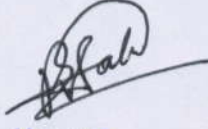
  
Manager  
PKM E.M. School, Dhaligaon  
Bongaigaon, Assam

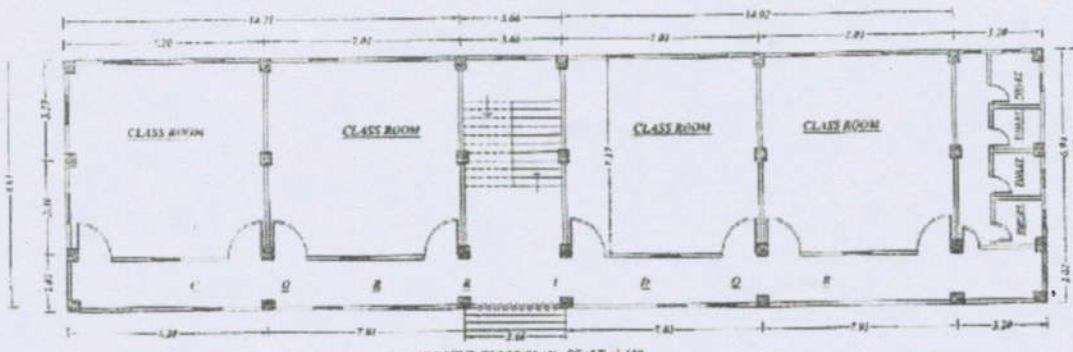


GROUND FLOOR PLAN - SCALE - 1:100  
RCC BLOCK NO-2

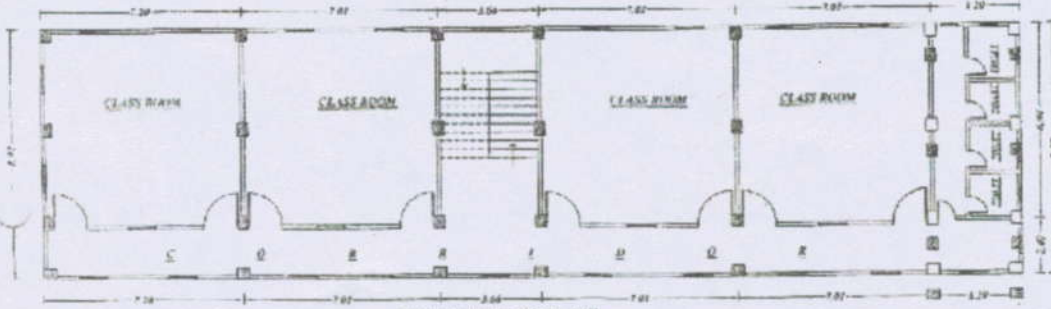

FIRST FLOOR PLAN - SCALE - 1:100  
RCC BLOCK NO-2

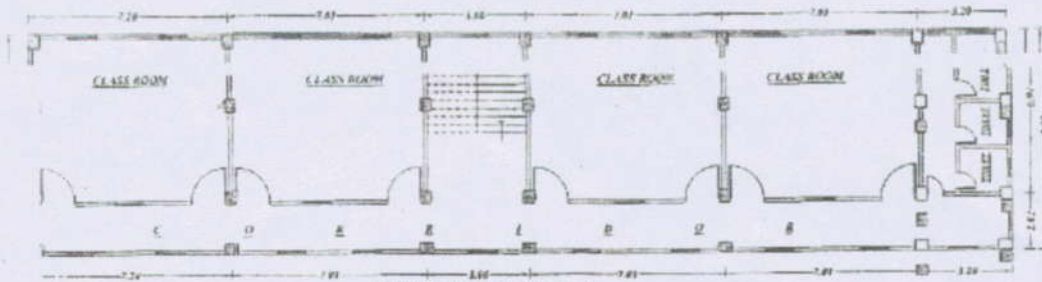

SECOND FLOOR PLAN - SCALE - 1:100  
RCC BLOCK NO-2

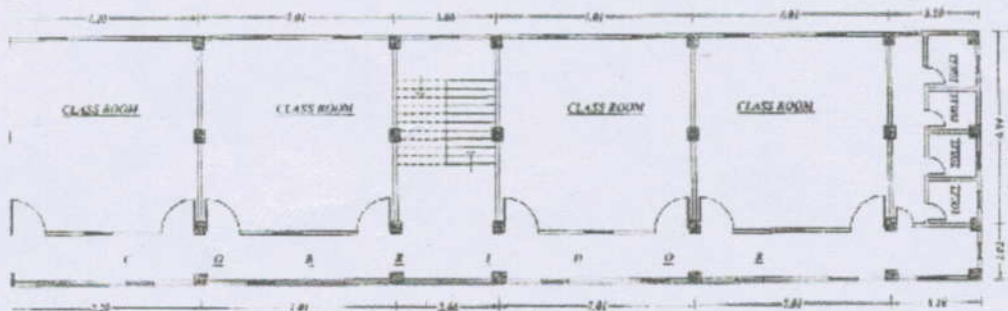

THIRD FLOOR PLAN - SCALE - 1:100  
RCC BLOCK NO-2



IN THIS DRAWING FOR FITNESS FOR SCHOOLS BUILDING OF MR. PRASANTA  
BRANMA AT THE VILLAGE - DALHIGON, P.O. - DALHIGON UNDER BONGAIGON  
DEVELOPMENT AUTHORITY AREA CONVEYED BY D.G. NO. 1661/1982, PART 4  
NO. 121/192, SC-DANAGIRI IN THE DIST. BONGMAYONG ASSAM

CONSULTANT ARCHITECT  
M. S. DAS GUPTA  
BONGAIGON

DESIGNED BY  
M. S. DAS GUPTA  
BONGAIGON

OWNER SIGNATURE  
*[Signature]*





*[Signature]*

Manager  
PKM E.M. School, Dhaligaon  
Bongaigaon, Assam

*[Signature]*

Principal  
PKM E.M. School, Dhaligaon  
Bongaigaon, Assam



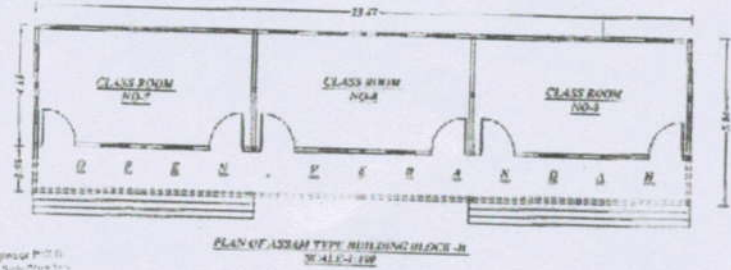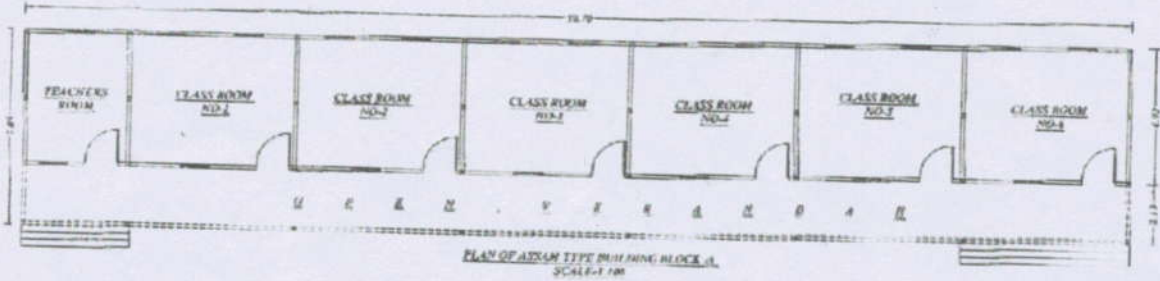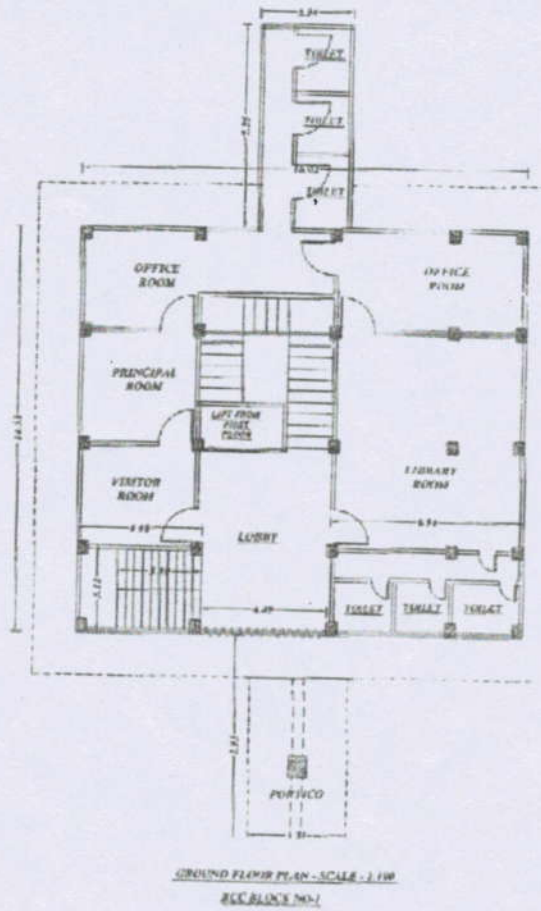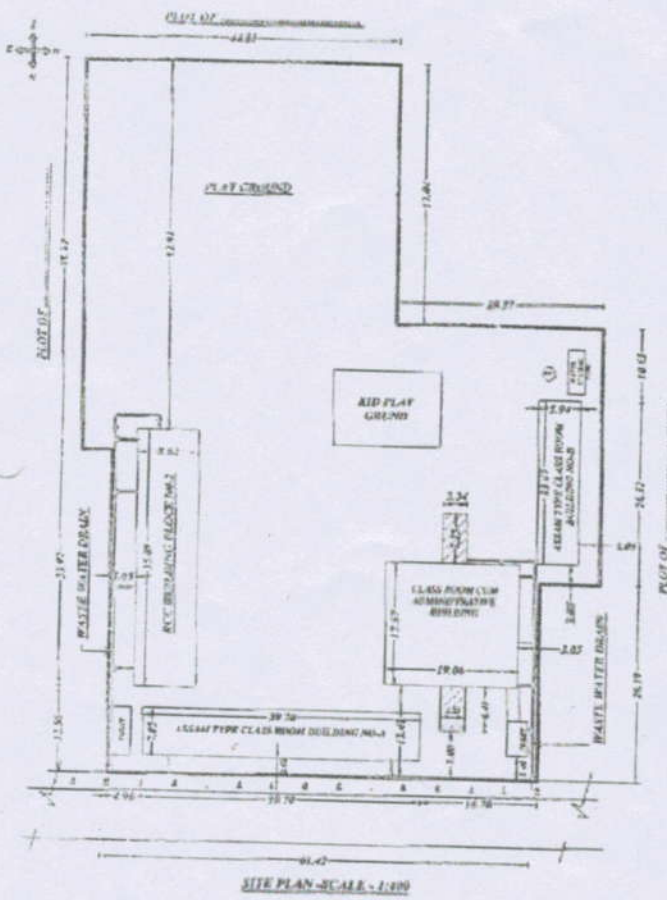

**USAGE OF THE BUILDING.**

NAME OF THE BUILDING	TOTAL FLOOR AREA IN SQ.M	CLASS ROOM AREA IN SQ.M	LIBRARY AREA IN SQ.M	OFFICE/PRINCIPAL AREA IN SQ.M	CLASS ROOMS PER UNIT
ASSAM TYPE BLOCK A	279.01	113.52			182.49
ASSAM TYPE BLOCK B	118.01	102.40			17.61
GT. TYPE BLOCK C	1831.63	204.30	14.20	21.50	1376.63
ALL TYPE BLOCK D	1225.64	126.10			478.74
<b>TOTAL</b>	<b>3454.30</b>	<b>346.32</b>	<b>14.20</b>	<b>21.50</b>	<b>2488.36</b>




**DETAIL DRAWING FOR FITNESS FOR SCHOOL BUILDING OF MR. PRAFULLA SAHAI AT THE 17th-18th - DAKSHIN DHALIGAON, P.O. - DHALIGAON UNDER BONGAIGAON DEVELOPMENT AUTHORITY AREA COVERED BY DAG NO. 18227/18227, PATTI NO. 131/18227 - BG-DANGTU, IN THE DIST. BONGAIGAON, ASSAM**

[Signature]  
**Manager**  
PKM E.M. School, Dhaligaon  
Bongaigaon, Assam

[Signature]  
**Principal**  
PKM E.M. School, Dhaligaon  
Bongaigaon, Assam

